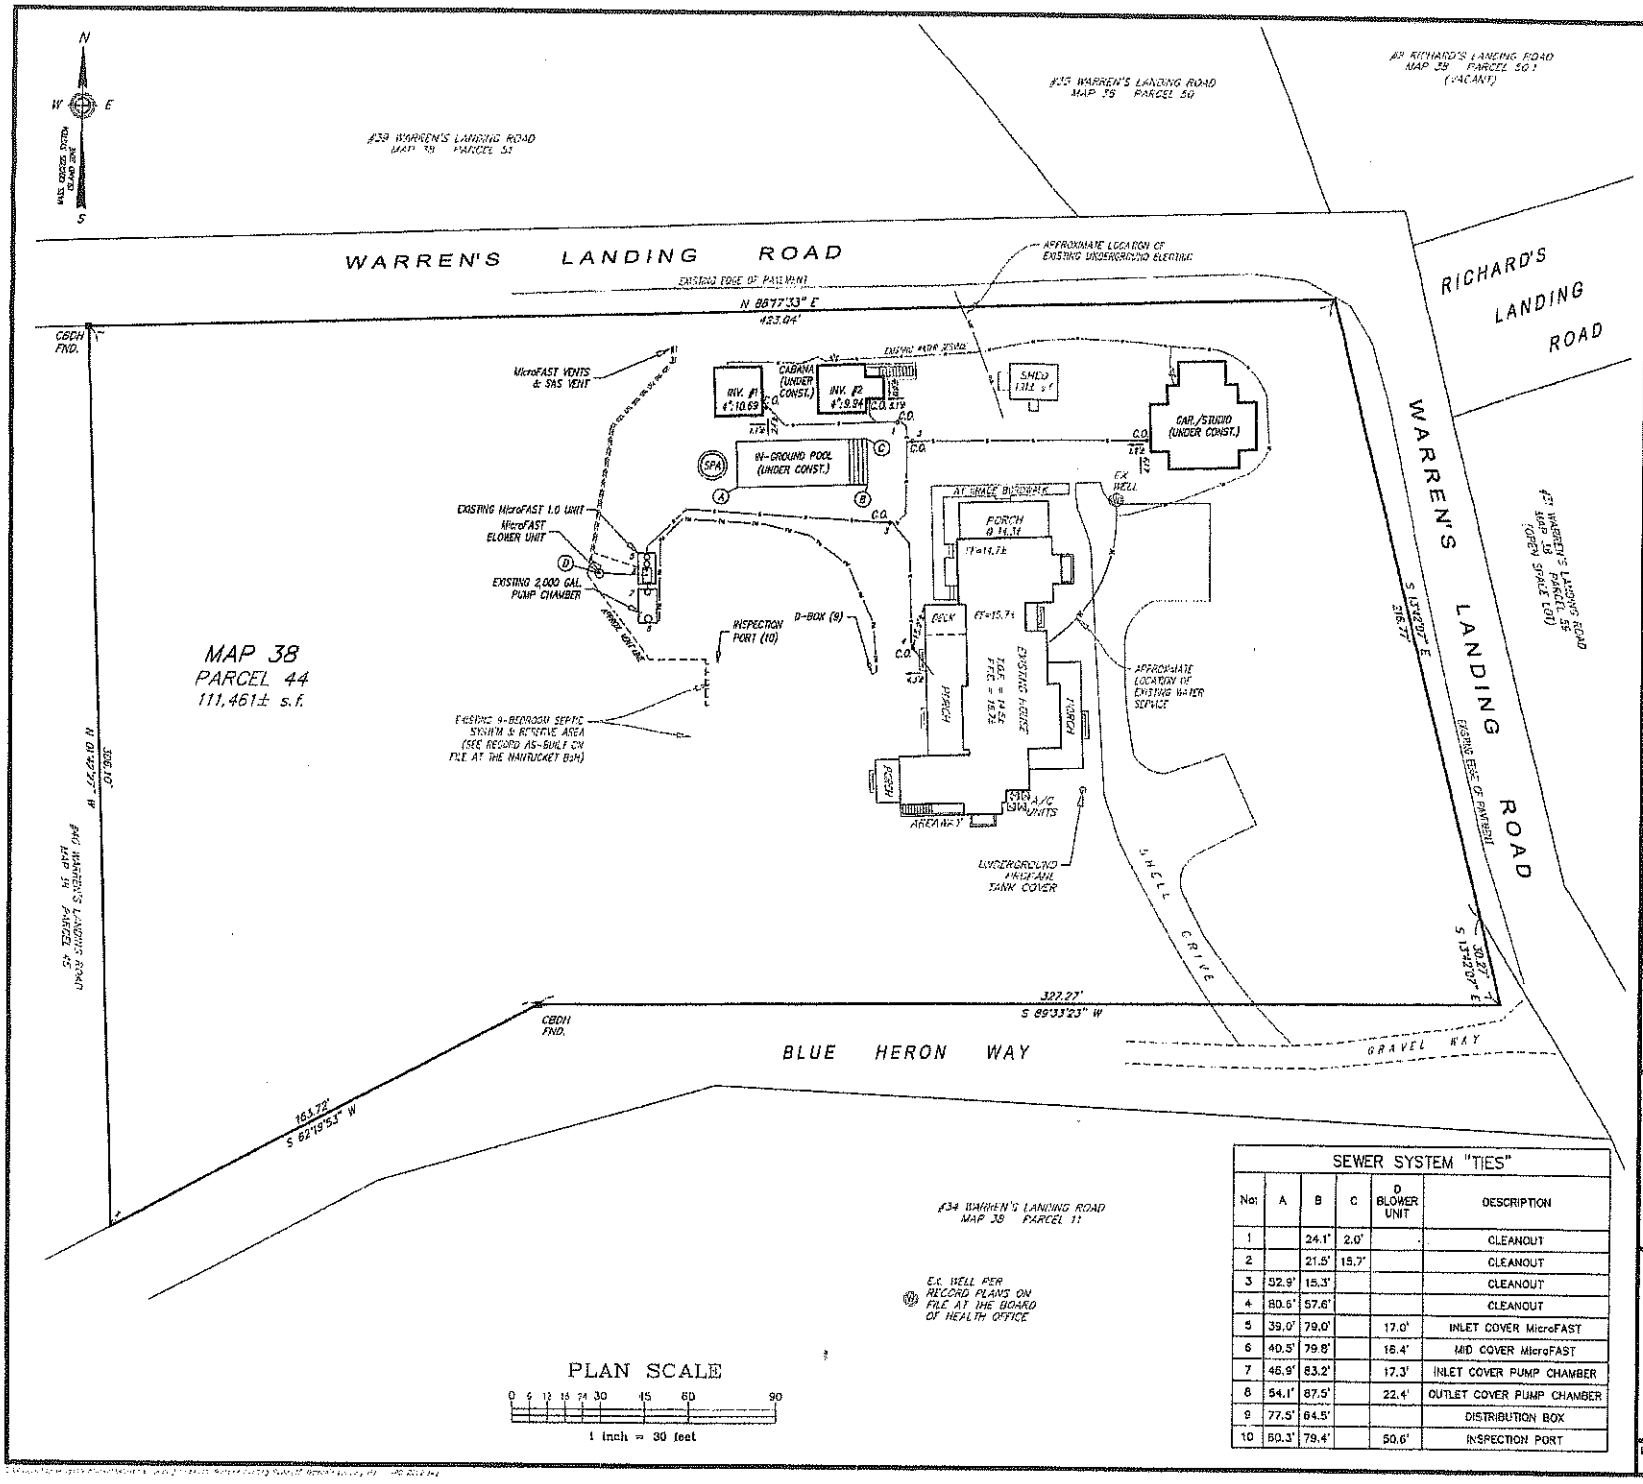

SEWER SYSTEM "TIES"					
No:	A	B	C	D BLOWER UNIT	DESCRIPTION
1		24.1'	2.0'		CLEANOUT
2		21.5'	15.7'		CLEANOUT
3	52.9'	15.3'			CLEANOUT
4	80.6'	57.6'			CLEANOUT
5	39.0'	79.0'		17.0'	INLET COVER MicroFAST
6	40.5'	79.8'		16.4'	MID COVER MicroFAST
7	46.9'	83.2'		17.3'	INLET COVER PUMP CHAMBER
8	54.1'	87.5'		22.4'	OUTLET COVER PUMP CHAMBER
9	77.5'	64.5'			DISTRIBUTION BOX
10	50.3'	79.4'		50.6'	INSPECTION PORT

Locus Map

Scale: 1" = 1,000'

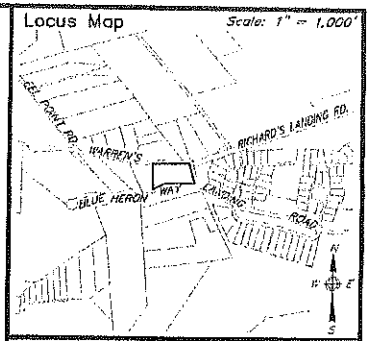

TO THE TOWN OF NANTUCKET:

"I CERTIFY THAT THE SEPTIC SYSTEM HAS BEEN CONSTRUCTED IN ACCORDANCE WITH THE TERMS OF THE PERMIT AND THE APPROVED DESIGN PLAN AND MEETS THE REQUIREMENTS OF THE TOWN AND STATE REGULATIONS. AS-BUILT".

DONALD F. BRACKEN, Jr., P.E.

INSTALLER – THOMAS CRADDOCK

INVERT SCHEDULE

INV. OUT CABANA #1	10.69
INV. OUT CABANA #2	9.94
INV. OUT GARAGE GUEST HOUSE	10.19
INV. AT HOUSE CONNECTION	11.12
INV. IN MicroFAST TANK	6.16
INV. OUT MicroFAST TANK	5.89
INV. IN PUMP CHAMBER	5.95
INV. OUT PUMP CHAMBER (FM)	6.02
INV. IN DISTRIBUTION BOX (FM)	10.39
INV. OUT DISTRIBUTION BOX	10.12

Prepared By:

BRACKEN ENGINEERING, INC.

40 HERRING POND ROAD
BUZZARDS BAY, MA 02532
(tel) 508.833.0070
(fax) 508.833.2262

19 OLD SOUTH ROAD
NANTUCKET, MA 02554
(tel) 508.325.0044
www.brackeneng.com

AS-BUILT SUBSURFACE SEWAGE DISPOSAL SYSTEM IN NANTUCKET, MASSACHUSETTS

Prepared For:

MARK & HILARY B. FINNEGAN

#36 WARREN'S LANDING ROAD
MAP 38 PARCEL 44

Date:	Drawn:	Checked:	Sheet:
SEPTEMBER 28, 2022	ERC/BEI	DFB/AMC	1 of 1